



Drawing: © 2010

Fax: (02) 9622 0450

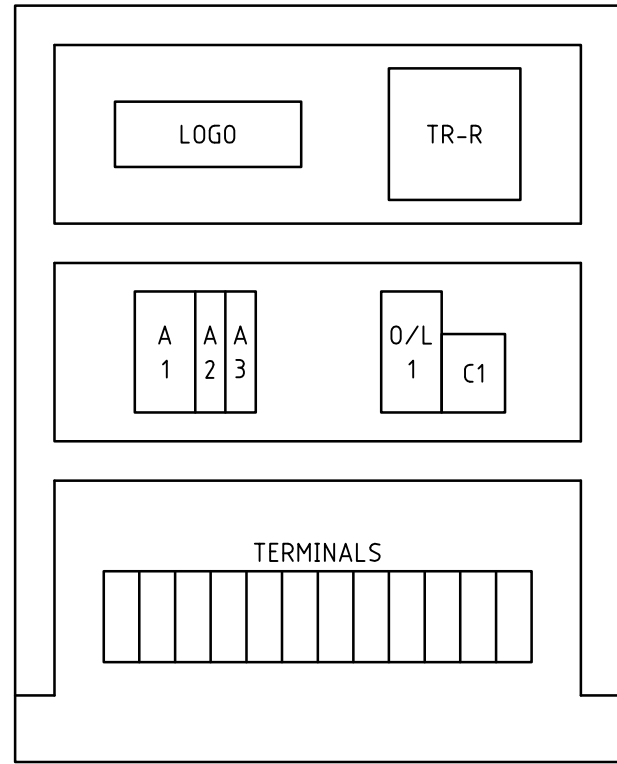


PANEL

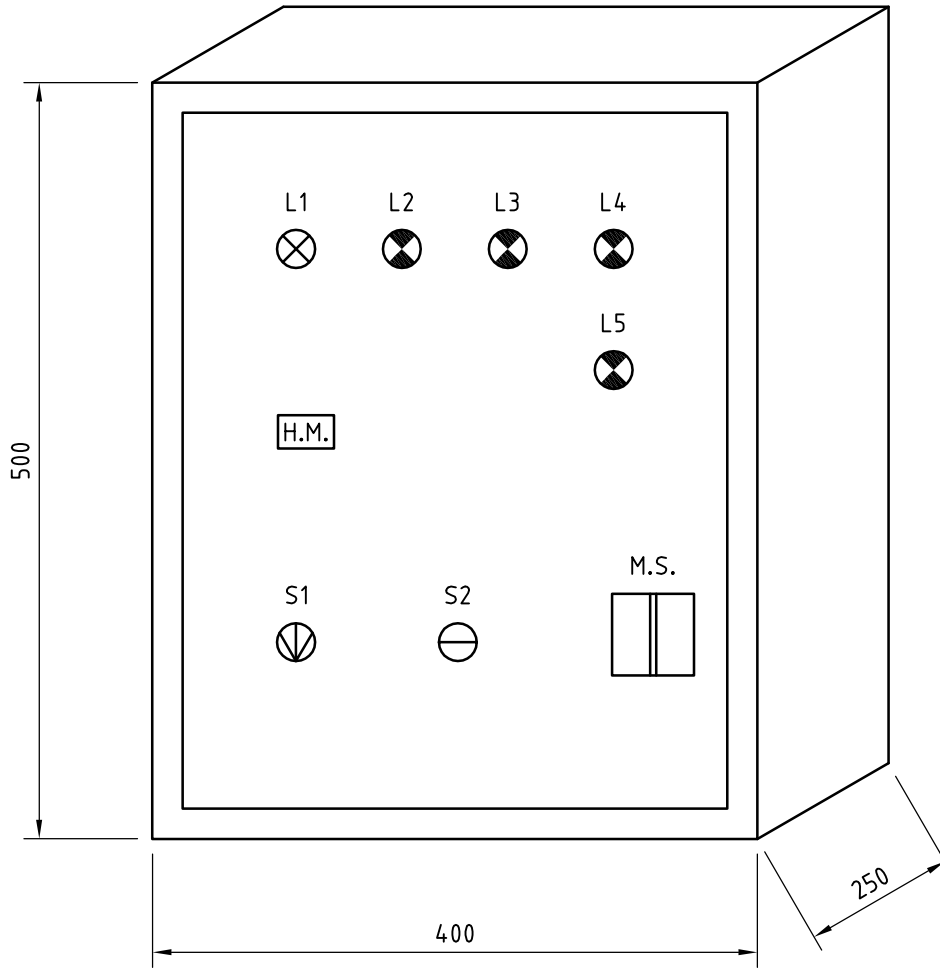

CUBICLE FRONT

TERMINALS

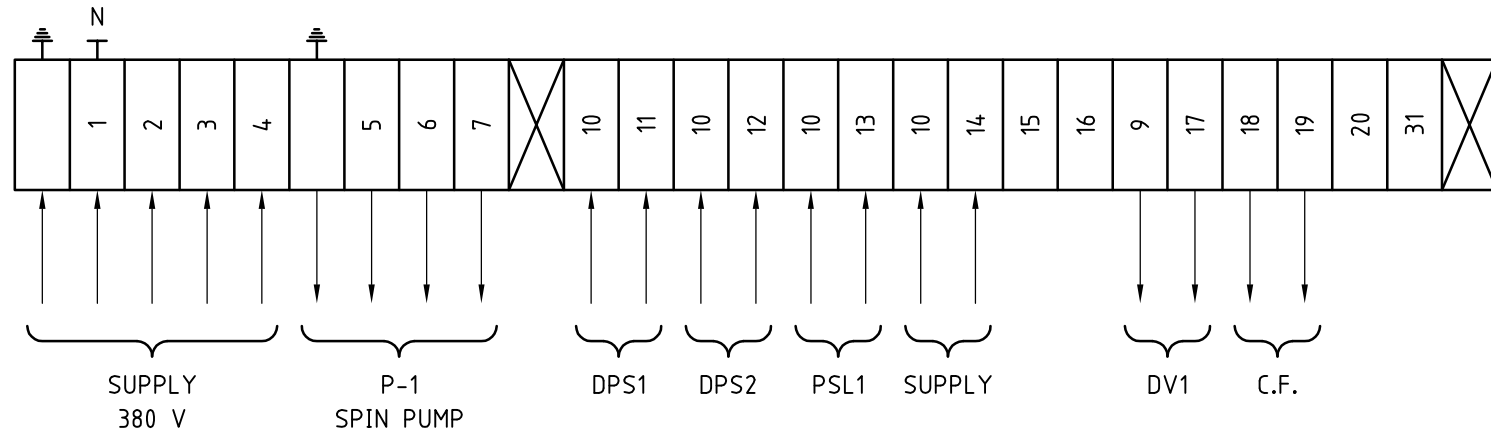

LEGEND

- L1 - μ F SPIN PUMP P-1 RUNNING
- L2 - μ F SPIN PUMP P-1 OVERLOAD FAILURE
- L3 - SCREEN FILTER HIGH PRESSURE DIFFERENTIAL (DPS1)
- L4 - μ F MEMBRANES HIGH PRESSURE DIFFERENTIAL (DPS2)
- L5 - LOW INLET PRESSURE (PSL1)
- S1 - P-1 PUMP SWITCH A-O-M
- S2 - RESET
- H.M. - HOUR METER (P-1)
- M.S. - MAIN SWITCH

AS BUILT

Drawing by WAI Engineering 282 mm

D

REV	BY	DATE	A.R.N.	DESCRIPTION	DRAWN TO	SCALE	CLIENT / PROJECT	DRAWING No.	REV
0	W	12-01-05	A4-0085	ORIGINAL ISSUE	AS 1100	N.T.S.	WATER TREATMENT PLANT	A4612005	1
1	W	08-02-05	A5-0003	AS BUILT	W	12-01-05		POTABLE WATER TREATMENT PLANT RIG 2, μ FILTRATION 2.5 m ³ /h, MAIN BOARD GENERAL ARRANGEMENT	C/CODE CWT-052
								JOB No. 101002	
								AutoCAD FILENAME	
								A4612005.DWG	

WAI Engineering
 2 Cumberland Street
 Blacktown, NSW. 2148
 Ph: 0418 203 229 A/H: (02) 9671 5873 Fax: (02) 9622 0450
 e-mail: support@wai.com.au

The information contained on this drawing is subject to Copyright protection. © Copyright WAI Engineering.